


REVISION HISTORY				
ZONE	REV	DESCRIPTION	DATE	APPROVED
	A	ADDED TWO 63 FINISH SYMBOLS	6/10/02 6/14/02	dm gls

13/64 CLR THRU HOLE  
.359 x .200 DP. C'BORE  
2 PLCS EQ. SPACED ON A  
5.250 DIA HOLE CIRCLE

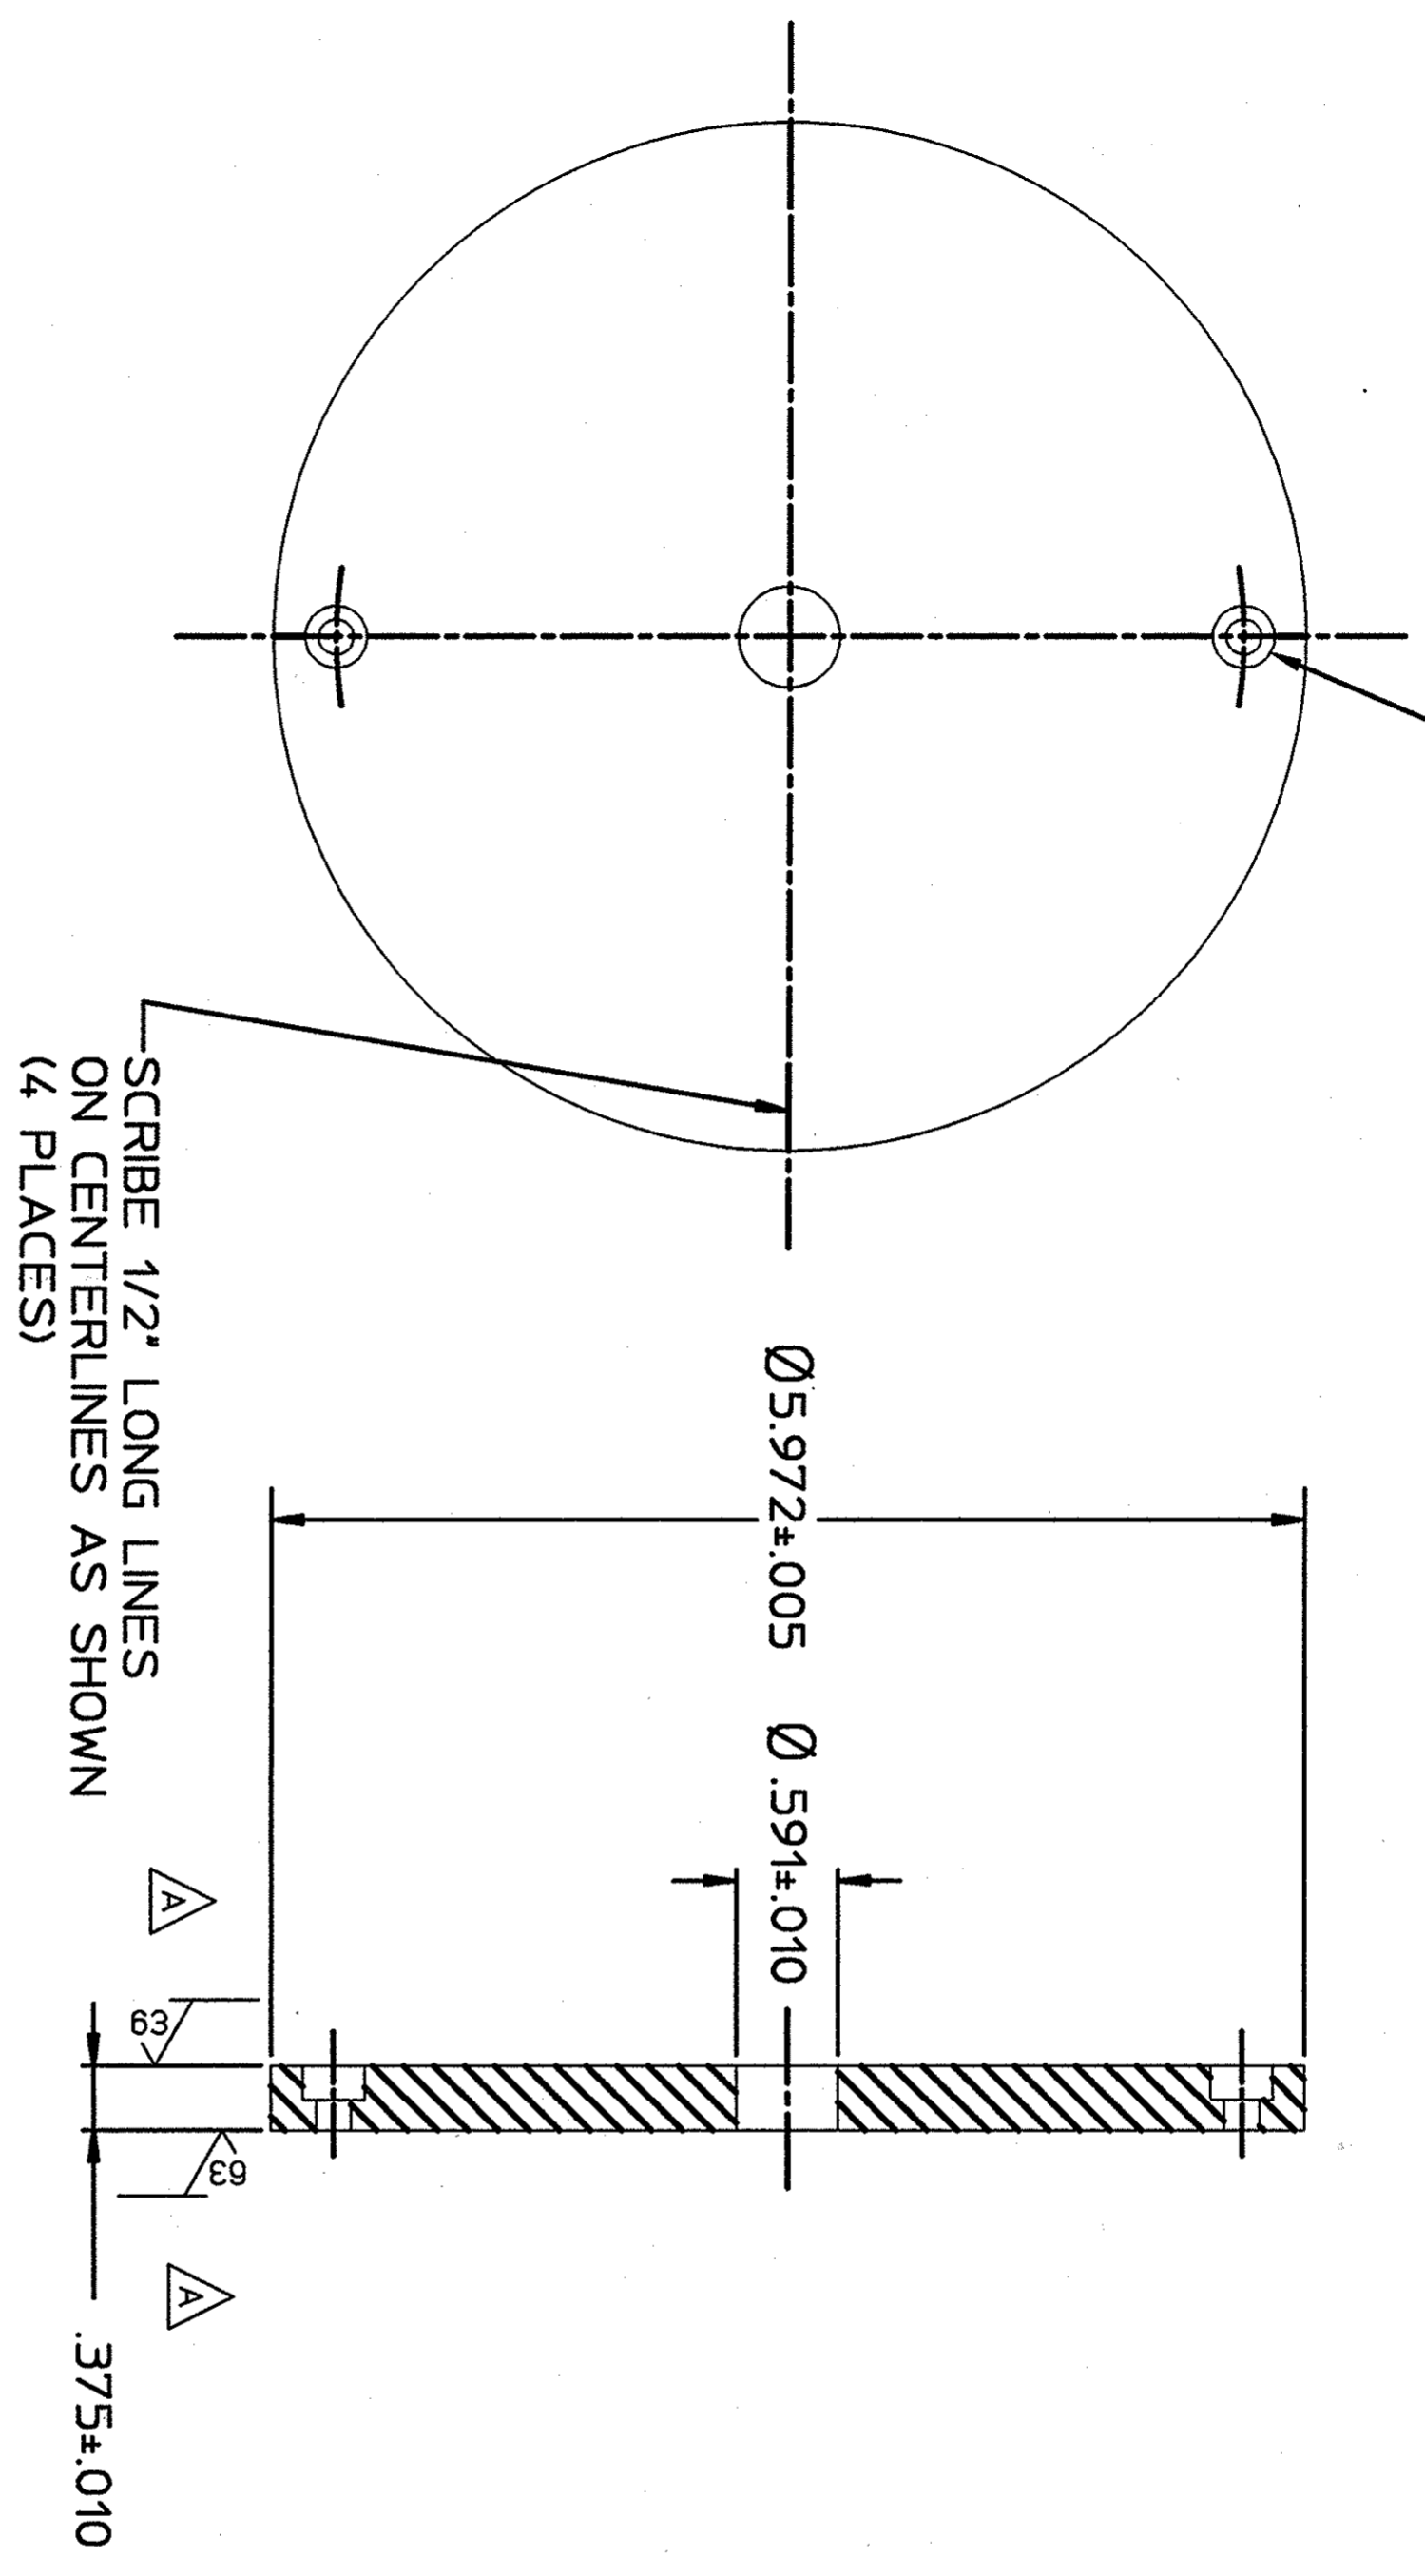

- NOTES:**
1. USE THE FOLLOWING JLAB SPECIFICATIONS:  
FABRICATION OF UHV EQUIPMENT: #22631-S-001.  
CLEANING AND HANDLING OF UHV COMPONENTS: #22632-S-001.
  2. 63 FINISH ALL OVER.
  3. MATERIAL SHALL BE NICKEL ALLOY 200. ALL ITEMS OF AN ORDER SHALL BE FABRICATED FROM THE SAME LOT OF MATERIAL.
  4. MATERIAL CERTIFICATION REQUIRED.

CADD I.D. NO. 328930011reVA		Thomas Jefferson National Accelerator Facility UNITED STATES DEPARTMENT OF ENERGY	
APPROVALS	DATE	 Jeffrey G. Galt National Director of Energy	WEN FILTER ASSEMBLY MAGNET END MIRROR
DRAWN C. L. HUTTON	11MAR97		
CHECKED D. MACHIE	6/26/97		
APPROVED		SIZE/DWG. NO. C 32893-C-0011	REV. A
CONST. RELEASE C. K. SINCLAIR		6/27/97	SHEET 1 OF 1
UNLESS OTHERWISE SPECIFIED		MAGNET END MIRROR	
NUCLEAR PHYSICS LABORATORY UNIVERSITY OF URBANA-CHAMPAIGN		PART NO. NO. REPT. 2 CHASSIS NO. OR MATERIAL	
DIMENSIONS IN INCHES: 2 PLACE DEC., 01 BREAK SHARP CORNERS 3 PLACE DEC., 003 FRACTIONAL-1/32 ANGLE 45°		SCALE 1=1	FILE 15
DRAWN BY URIBE	APPROVED BY	DATE 9-15-92	DWG. NO. C-2893-11